



NOTES  
DO NOT SCALE FROM THIS DRAWING  
**PROPOSED**

Existing brick wall London stock

Copper cladding

B

Blue roof

Sliding glass panel

fully openable  
rooflight to create  
indoor /outdoor  
atrium space

A

Blue roofs

Sliding glass panel

Existing staircase

fully openable  
rooflight to create  
indoor /outdoor  
atrium space

Blue roof

Garden

Garden

Garden

Bedroom

Bedroom

Bedroom

Terrace

Bedroom

bath

bath

bath

bedroom

Kitchen

bedroom

dinner

living

bedroom


bedroom

bath

bedroom

bedroom

bedroom

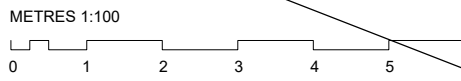

Rev C: Final plan as built 06.03.2021  
Rev B: Lift and notes added 05.05.2016  
Rev A: Scale bar added & project name changed to 10B 14.03.2016

**Martin Evans**  
Architects  
18 Charlotte Road  
London EC2A 3PB  
tel 020 7729 2474

**PROJECT**  
10B BELMONT STREET  
NW1 8HJ London

**TITLE**  
PROPOSED ROOF PLAN

<b>DATE</b>	18.06.15
<b>SCALE</b>	1:100 @ A3
<b>DRAWN BY</b>	AF

**DRAWING NO.** BEL-PL-GA-06C