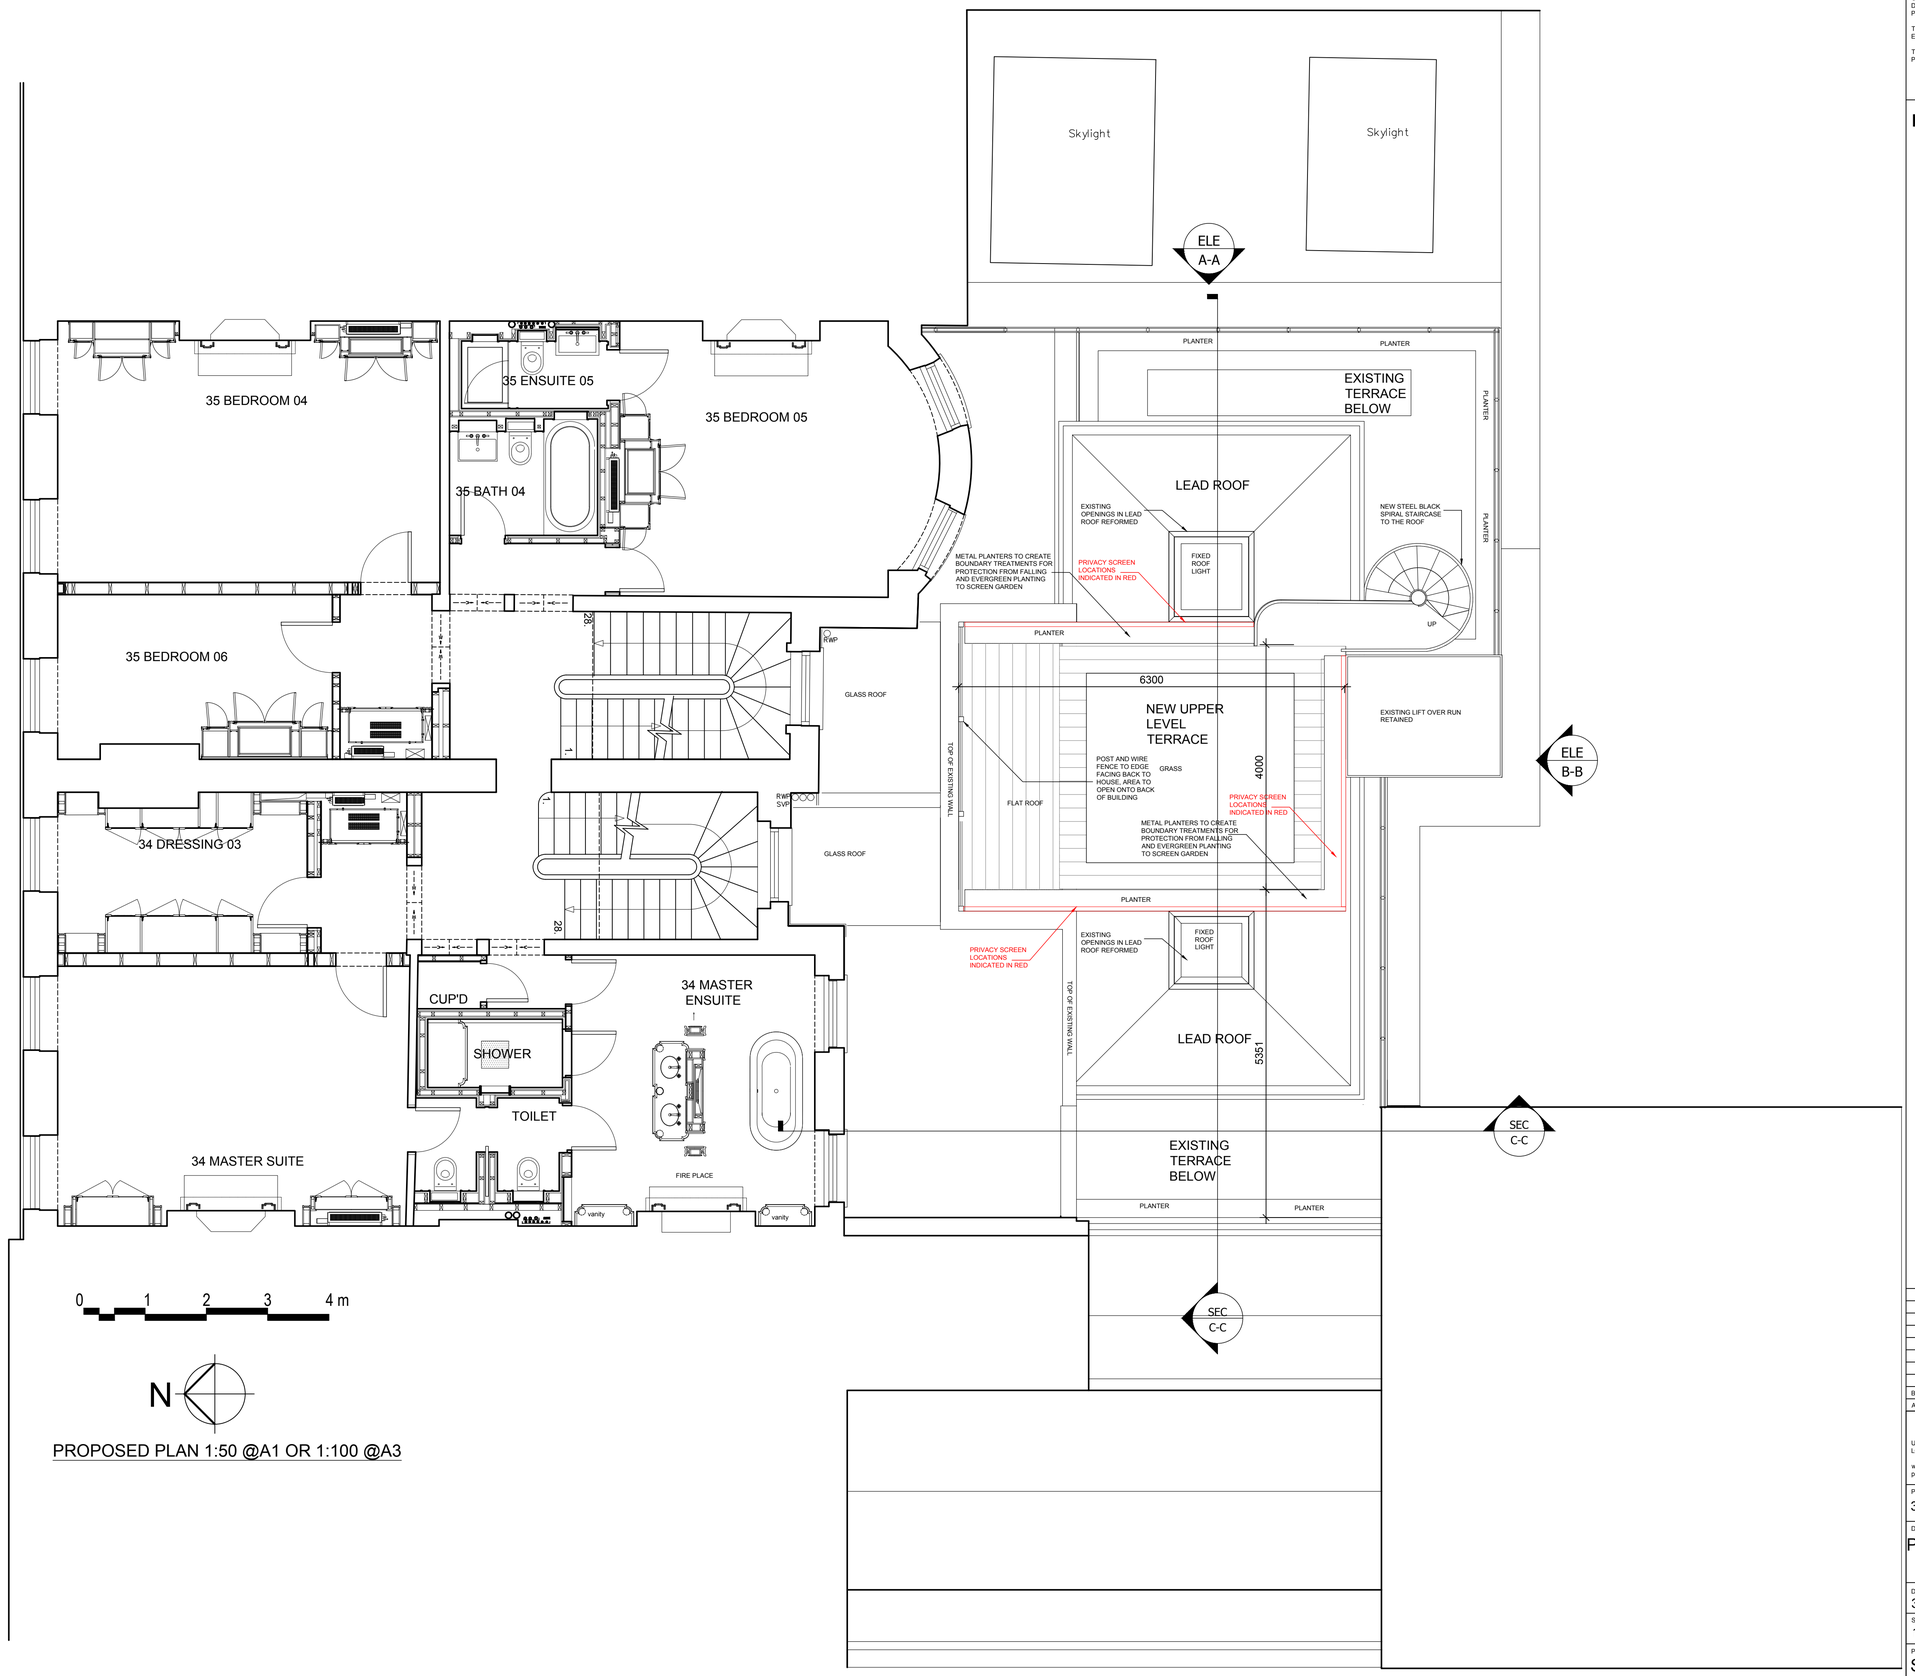

PROPOSED PLAN 1:50 @A1 OR 1:100 @A3

CONTRACTOR IS TO CHECK AND VERIFY ALL BUILDING AND SITE DIMENSIONS, LEVELS AND SEWER INVERT LEVELS AT CONNECTION POINTS BEFORE WORK STARTS

THIS DRAWING IS TO BE READ AND CHECKED IN CONJUNCTION WITH ENGINEERS AND OTHER SPECIALIST DRAWINGS

THE DRAWING AND THE WORKS DEPICTED ARE THE INTELLECTUAL PROPERTY OF INK BESPOKE LIMITED

NOTE

FOR INFORMATION ONLY

B	SEPT 2021	PRIVACY SCREEN LOCATIONS INDICATED IN RED
A	JULY 2018	LIFT OVERRUN RETAINED

UNIT 4, 101 UNION STREET
LONDON, SE1 0LQ

www.inkbespoke.com
project@inkbespoke.com

INK BESPOKE

PROJECT
3435 FITZROY SQUARE

DRAWING TITLE
PROPOSED SECOND FLOOR

DRAWING NUMBER
3435 - (P1) - 203

REVISION
B

SCALE
1:50@A1

ISSUE DATE
2017-09-10

PROJECT STATUS
STAGE 4

DRAWN BY
MC

CHECKED BY
KS