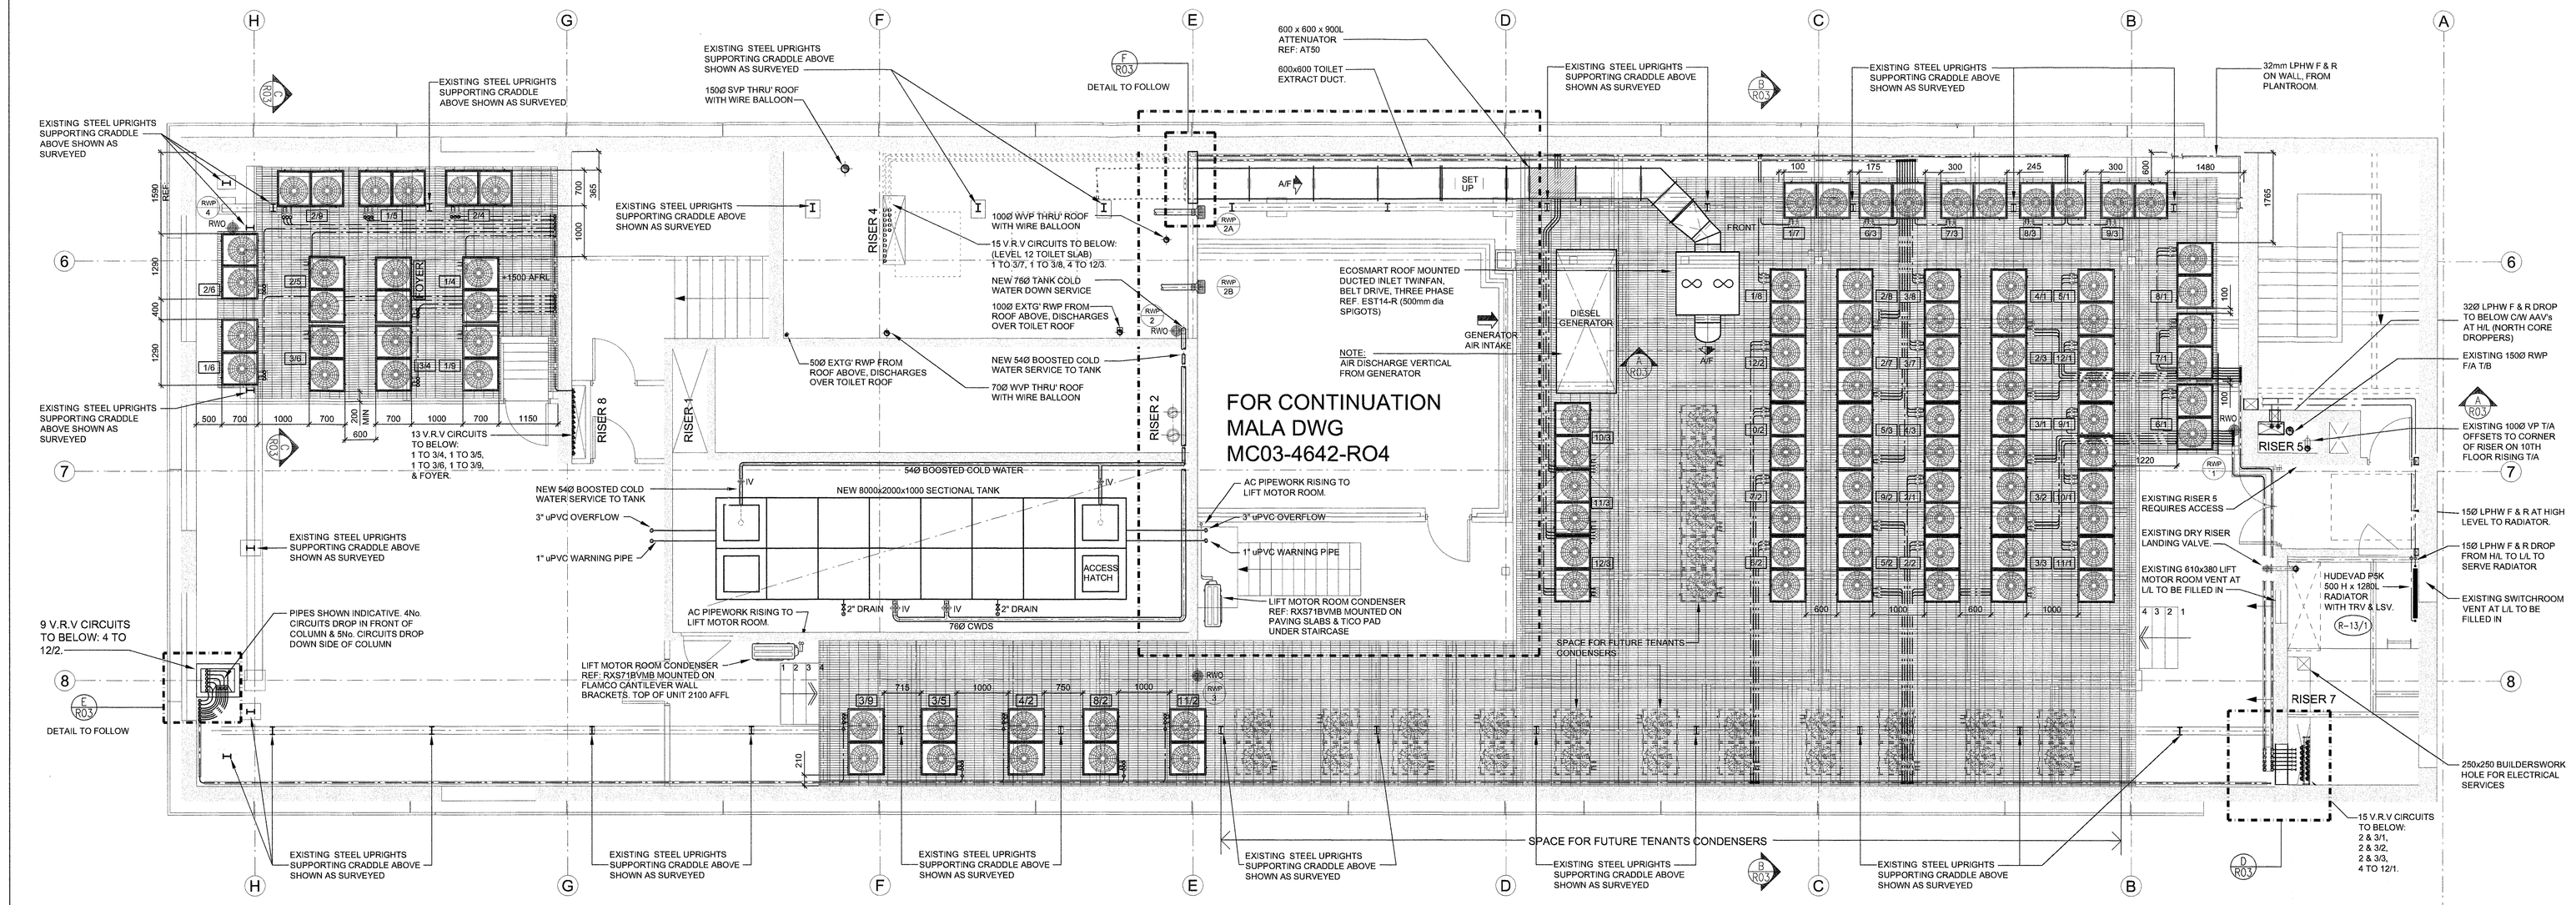

ROOF CONDENSER UNIT SCHEDULE

UNIT REFERENCE	TYPE	MANUFACTURER
FOYER	RSEYP10K	DAIKIN
1/4	RSEYP10K	DAIKIN
1/5	RSEYP8K	DAIKIN
1/6	RSXYP10L	DAIKIN
1/7	RSEYP8K	DAIKIN
1/8	RSEYP10K	DAIKIN
1/9	RSEYP10K	DAIKIN
2/1	RSEYP10K	DAIKIN
2/2	RSEYP8K	DAIKIN
2/3	RSXYP8L	DAIKIN
2/4	RSEYP10K	DAIKIN
2/5	RSEYP10K	DAIKIN
2/6	RSXYP8L	DAIKIN
2/7	RSEYP8K	DAIKIN
2/8	RSEYP10K	DAIKIN
2/9	RSEYP10K	DAIKIN
3/1	RSEYP10K	DAIKIN
3/2	RSEYP8K	DAIKIN
3/3	RSXYP8L	DAIKIN
3/4	RSEYP10K	DAIKIN
3/5	RSEYP10K	DAIKIN
3/6	RSXYP8L	DAIKIN
3/7	RSEYP8K	DAIKIN
3/8	RSEYP10K	DAIKIN
3/9	RSEYP10K	DAIKIN
4/1	RSEYP10K	DAIKIN
4/2	RSEYP10K	DAIKIN
4/3	RSEYP10K	DAIKIN
5/1	RSEYP10K	DAIKIN
5/2	RSEYP10K	DAIKIN
5/3	RSEYP10K	DAIKIN
6/1	RSEYP10K	DAIKIN
6/2	RSEYP10K	DAIKIN
6/3	RSEYP10K	DAIKIN
7/1	RSEYP10K	DAIKIN
7/2	RSEYP10K	DAIKIN
7/3	RSEYP10K	DAIKIN
8/1	RSEYP10K	DAIKIN
8/2	RSEYP10K	DAIKIN
8/3	RSEYP10K	DAIKIN
9/1	RSEYP10K	DAIKIN
9/2	RSEYP10K	DAIKIN
9/3	RSEYP10K	DAIKIN
10/1	RSEYP10K	DAIKIN
10/2	RSEYP10K	DAIKIN
10/3	RSEYP10K	DAIKIN
11/1	RSEYP10K	DAIKIN
11/2	RSEYP10K	DAIKIN
11/3	RSEYP10K	DAIKIN
12/1	RSEYP10K	DAIKIN
12/2	RSEYP10K	DAIKIN
12/3	RSEYP10K	DAIKIN
ROOF LIFT MOTOR ROOM 2 No.	RXS71BVMB	DAIKIN

RADIATOR SCHEDULE

REFERENCE	LOCATION	FLOOR	MAKE	TYPE	SIZE HxW	OUTPUT (WATTS)	CONNECTIONS
R-13/1	SWITCHROOM	ROOF	HUDEVAD	P5K	500x1280	1017	15mm

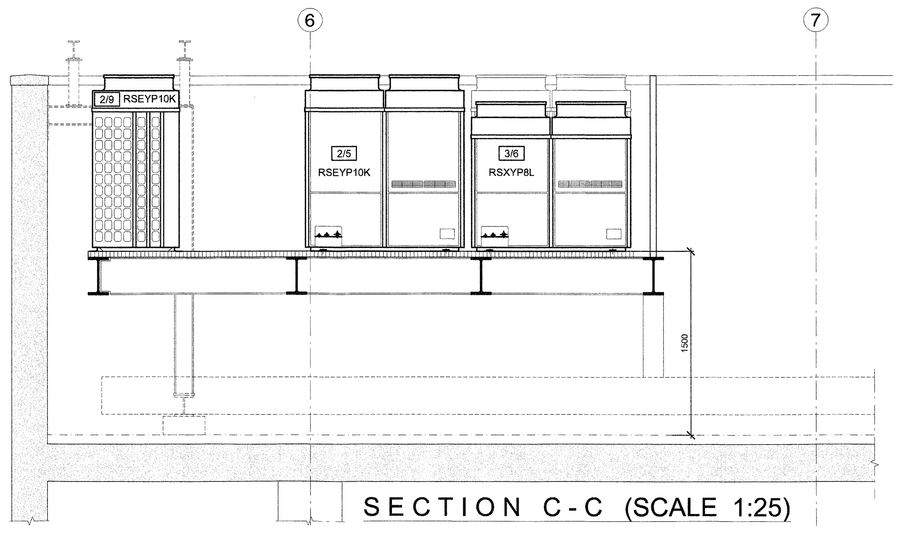

SECTION C-C (SCALE 1:25)

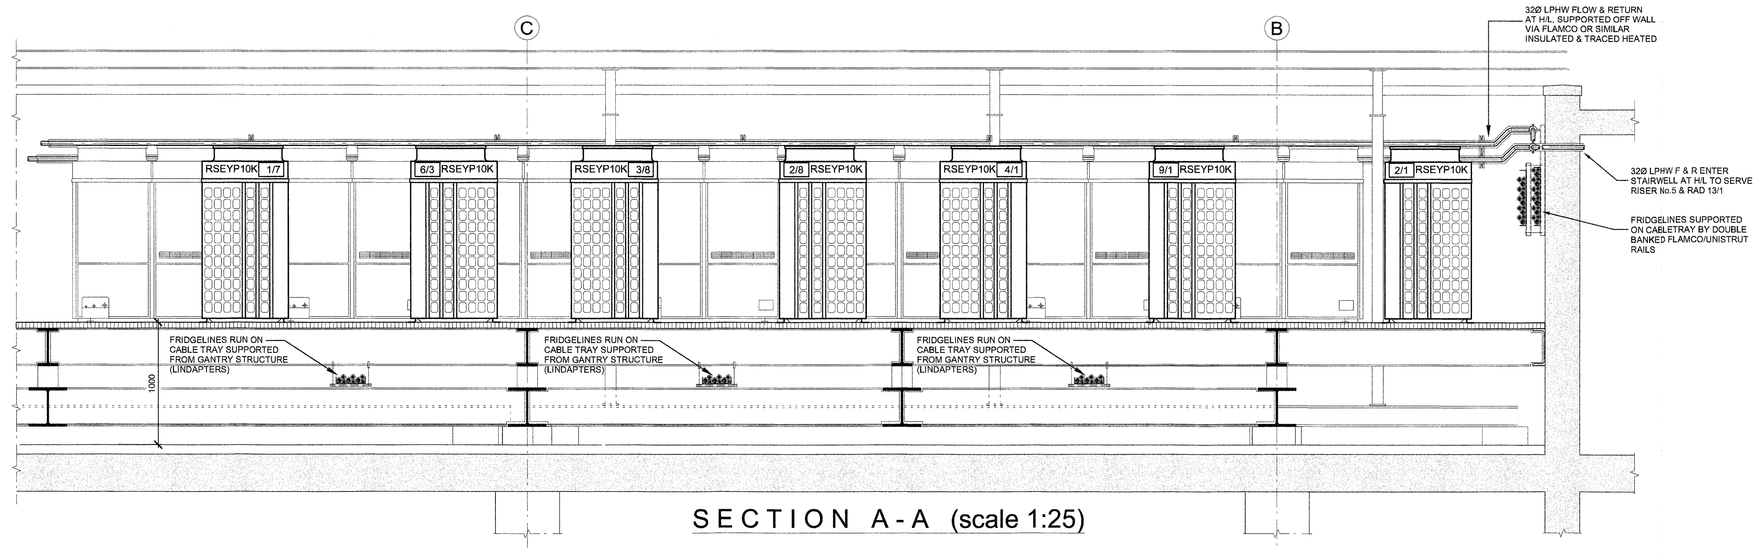

SECTION A-A (scale 1:25)

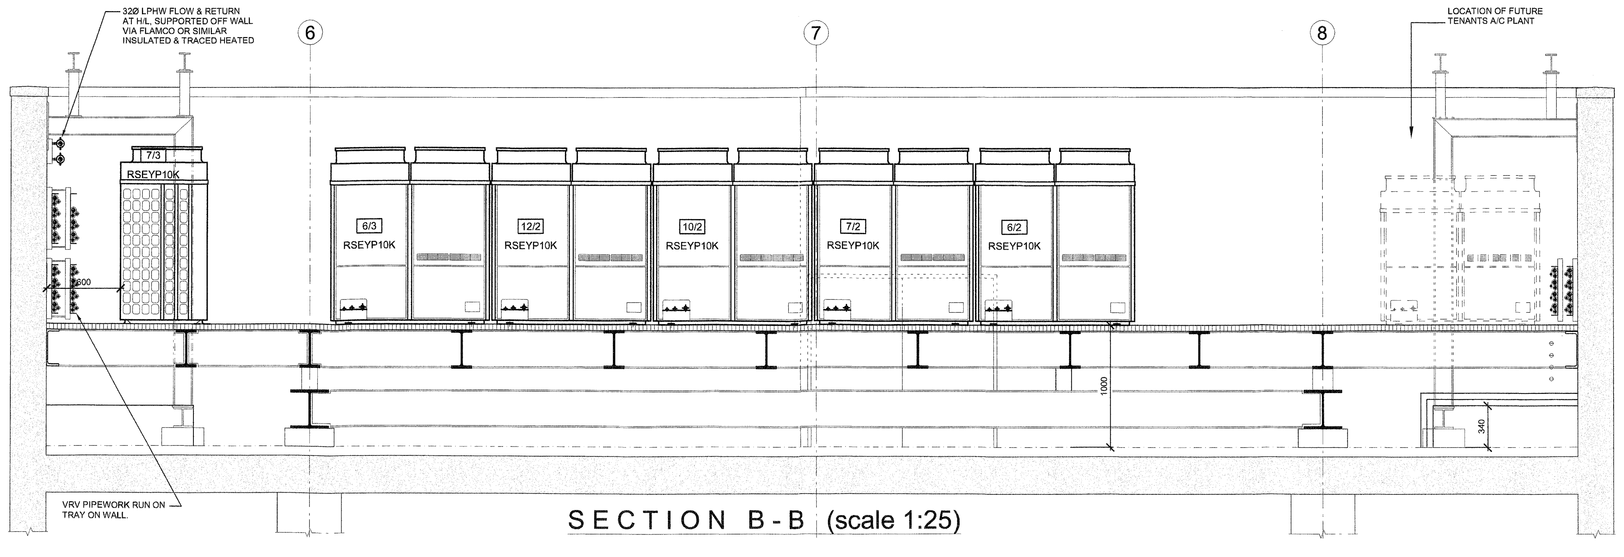

SECTION B-B (scale 1:25)

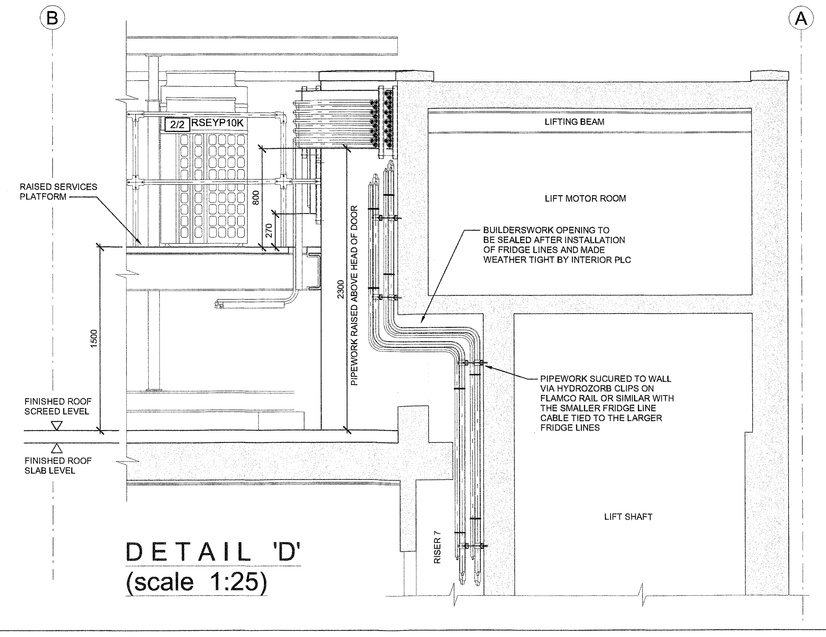

DETAIL 'D' (scale 1:25)

RECORD DRAWING

DATE	REVISION	No.
14.11.06	NEW SECTIONAL TANK REPLACES EXISTING	

CONTRACT
METROPOLIS HOUSE
TOTTENHAM COURT ROAD
LONDON

TITLE
TOWER BLOCK ROOF
MECHANICAL SERVICES
LAYOUT

ARCHITECT
ORMS

CONSULTANT
ERNEST GRIFFITHS

MALA
126 Pelherton Road
London N5 2RT
Tel: 0207-359 3825
Fax: 0207-359 4672
Email: mala@mala.co.uk

SCALE 1:50/25 | DATE MAR 05
DRAWN SG/PJM | DRG No. MC03 / 4642 / M-RD09