


Comparative Rear Elevation

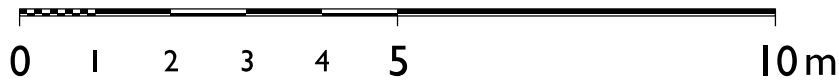

PREVIOUS PROPOSED LAYOUT FROM
PLANNING APPLICATION 2020/1357/P
INDICATED IN GREEN

XAB
ARCHITECTS
T +44 20 3282 7585 WWW.XAB.CO.UK

Project:
44 CHALCOT ROAD
LONDON, NW1 8LS

Drawing Title:
**Comparative Elevations
REAR ELEVATION**

Project No:
21016

Scale:
1:100 @ A3

Status:
PRELIMINARY

Drawing No.
251

Revision:
P2

This drawing must not be scaled for construction.