

Notes:	Issue ID	Issue Name	Date	Notes:
All dimensions must be checked and UVAdesign Ltd is to be informed of any discrepancies prior to construction. All drawings prepared by UVAdesign Ltd are not to be used for any submissions, area schedule calculation or used by any other persons or companies other than UVAdesign Ltd unless written consent has been given by UVAdesign Ltd.	00	Issue for planning	26/01/2022	

Notes:


T: +44 (0) 20 7371 57 97
E: hello@uvadesign.co.uk
W: www.uvadesign.co.uk
A: 88 Peterborough road
Fulham SW6 3HH

UVAdesign Ltd

Project:
Former Hampstead Police Station Stables
London NW3 1PD

Layout Title:
DEMOLITION MARK UP
Floor plans
Status:
Planning

Issue date	Drawn by	Project code	Number	Rev
26/01/2022	@A3	113-21	DM.01	00
Scale:				
1:100				

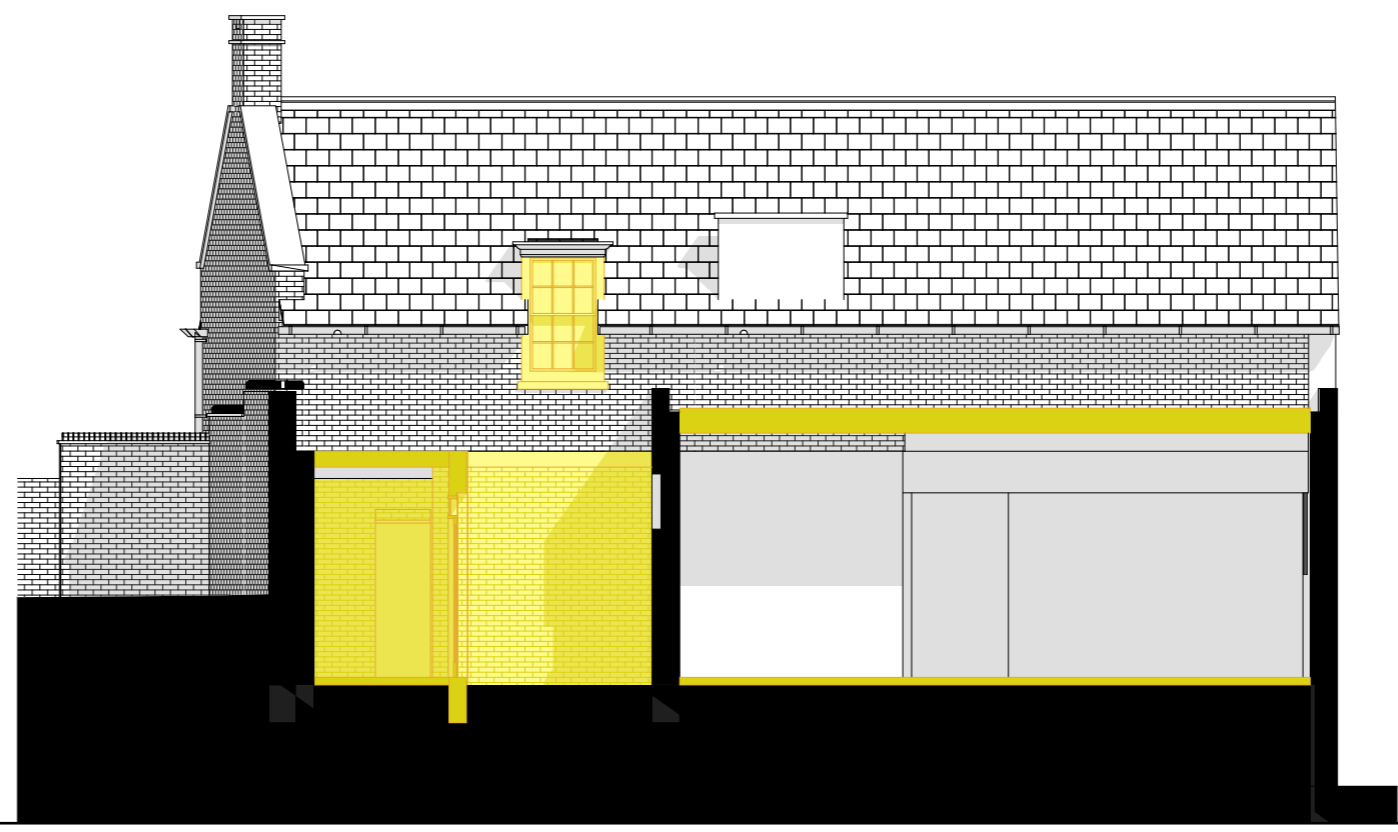

AREA NOT SUBJECT TO WORKS

Notes: All dimensions must be checked and UVAdesign Ltd is to be informed of any discrepancies prior to construction. All drawings prepared by UVAdesign Ltd are not to be used for any submissions, area schedule calculation or used by any other persons or companies other than UVAdesign Ltd unless written consent has been given by UVAdesign Ltd.	Issue ID	Issue Name	Date	Notes:	T: +44 (0) 20 7371 57 97 E: hello@uvadesign.co.uk W: www.uvadesign.co.uk A: 88 Peterborough road Fulham SW6 3HH	Project: Former Hampstead Police Station Stables London NW3 1PD	Layout Title: DEMOLITION MARK UP Elevations and Sections	Issue date	Drawn by	Project code	Number	Rev	
	00	Issue for planning	26/01/2022					26/01/2022	@A3	113-21	DM.03	00	
					UVAdesign Ltd	Project: Former Hampstead Police Station Stables London NW3 1PD	Layout Title: DEMOLITION MARK UP Elevations and Sections	Scale:					
								1:100	Status: Planning				



Notes: All dimensions must be checked and UVAdesign Ltd is to be informed of any discrepancies prior to construction. All drawings prepared by UVAdesign Ltd are not to be used for any submissions, area schedule calculation or used by any other persons or companies other than UVAdesign Ltd unless written consent has been given by UVAdesign Ltd.	Issue ID	Issue Name	Date	Notes:	T: +44 (0) 20 7371 57 97 E: hello@uvadesign.co.uk W: www.uvadesign.co.uk A: 88 Peterborough road Fulham SW6 3HH	Project: Former Hampstead Police Station Stables London NW3 1PD	Layout Title: DEMOLITION MARK UP Elevations and Sections	Issue date	Drawn by	Project code	Number	Rev
	00	Issue for planning	26/01/2022					26/01/2022	@A3	113-21	DM.04	00

