


- - - Original Consented Red line boundary
- Proposed area for amendments

C1	For Planning	23.03.22	MAG	KL
Rev	Description	Date	Dr by	App by
original by	date created	approved by		
Author	06/17/21	Approver		

**AHR** AHR London Ltd  
 5-8 Hardwick Street  
 London  
 EC1R 4RG  
 United Kingdom

T +44(0)20 78379789  
 E london@ahr.co.uk  
 www.ahr.co.uk

client name		
GM London		
project		
19-37 Highgate Road		
drawing		
Location Plan		
computer file	plot date	
C:\Revit Project\HR-AHR-ZZ-M3-A-001_Maria.Georgieva.rvt	16.06.21	
project number	scale	
2019.00386.001	1 : 1250 @A3	
drawing number	rev	issue status
HR-AHR-B1-00-DR-A-11-000	C1	S1

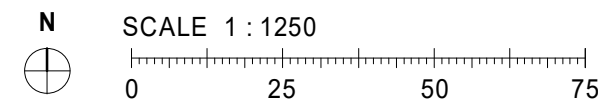

This drawing is to be read in conjunction with all related drawings. All dimensions must be checked and verified on site before commencing any work or producing shop drawings. The originator should be notified immediately of any discrepancy. This drawing is copyright and remains the property of AHR.