

Issue ID	Issue Name	Date
01	Issue for planning	14/05/2022
00	Issue for planning	26/01/2022

Notes:
All dimensions must be checked and UVAdesign Ltd is to be informed of any discrepancies prior to construction.
All drawings prepared by UVAdesign Ltd are not to be used for any submissions, area schedule calculation or used by any other persons or companies other than UVAdesign Ltd unless written consent has been given by UVAdesign Ltd.

T: +44 (0) 20 7371 57 97
 E: hello@uvadesign.co.uk
 W: www.uvadesign.co.uk
 A: 88 Peterborough road
 Fulham SW6 3HH



Project:	Former Hampstead Police Station Stables London NW3 1PD
Layout Title:	DEMOLITION MARK UP Floor plans
Status:	Planning

Issue date:	14/05/2022	Drawn by:	@A3	Project code:	113-21	Number:	DM.01	Rev:	01
Scale:	1:100								



Issue ID	Issue Name	Date
01	Issue for planning	14/05/2022
00	Issue for planning	26/01/2022

Notes:

T: +44 (0) 20 7371 57 97
E: hello@uvadesign.co.uk
W: www.uvadesign.co.uk
A: 88 Peterborough road
Fulham SW6 3HH




Project:
Former Hampstead Police Station Stables
London NW3 1PD

Layout Title:
DEMOLITION MARK UP
Elevations and Sections
Status:
Planning

Issue date	Drawn by	Project code	Number	Rev
14/05/2022		113-21	DM.02	01
Scale:				
1:100	@A3			

Notes:
All dimensions must be checked and UVAdesign Ltd is to be informed of any discrepancies prior to construction.
All drawings prepared by UVAdesign Ltd are not to be used for any submissions, area schedule calculation or used by any other persons or companies other than UVAdesign Ltd unless written consent has been given by UVAdesign Ltd.

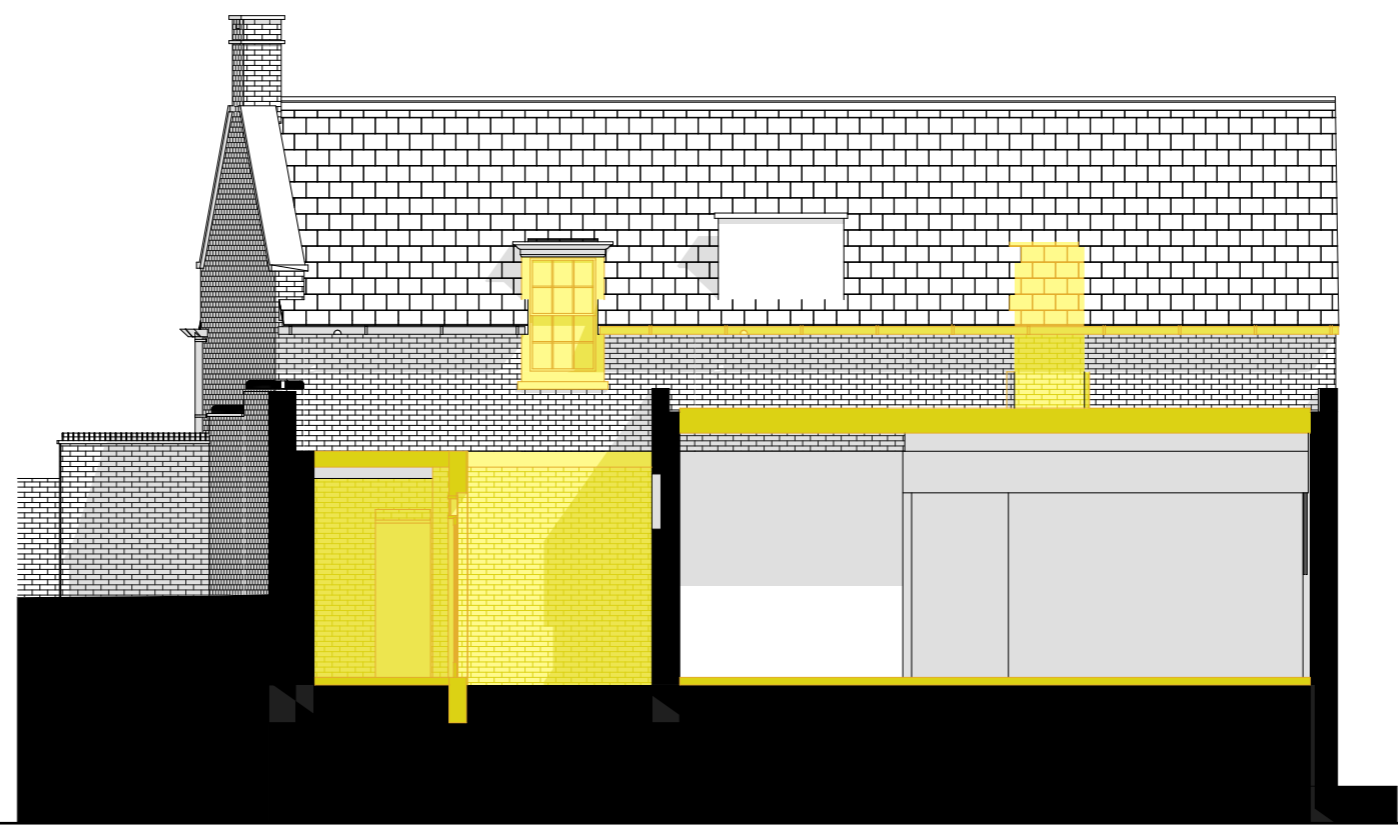

Issue ID	Issue Name	Date	Notes
01	Issue for planning	14/05/2022	
00	Issue for planning	26/01/2022	

Notes:
All dimensions must be checked and UVAdesign Ltd is to be informed of any discrepancies prior to construction.
All drawings prepared by UVAdesign Ltd are not to be used for any submissions, area schedule calculation or used by any other persons or companies other than UVAdesign Ltd unless written consent has been given by UVAdesign Ltd.

T: +44 (0) 20 7371 57 97
E: hello@uvadesign.co.uk
W: www.uvadesign.co.uk
A: 88 Peterborough road
Fulham SW6 3HH



Project:
Former Hampstead Police Station Stables
London NW3 1PD

Layout Title:
DEMOLITION MARK UP
Elevations and Sections
Status:
Planning

Issue date	Drawn by	Project code	Number	Rev
14/05/2022		113-21	DM.03	01
Scale:				
	@A3			



Issue ID	Issue Name	Date
01	Issue for planning	14/05/2022
00	Issue for planning	26/01/2022

Notes:

T: +44 (0) 20 7371 57 97
E: hello@uvadesign.co.uk
W: www.uvadesign.co.uk
A: 88 Peterborough road
Fulham SW6 3HH



Project:
Former Hampstead Police Station Stables
London NW3 1PD

Layout Title:
DEMOLITION MARK UP
Elevations and Sections
Status:
Planning

Issue date	Drawn by	Project code	Number	Rev
14/05/2022		113-21	DM.04	01
Scale:				
1:100	@A3			

Notes:
All dimensions must be checked and UVAdesign Ltd is to be informed of any discrepancies prior to construction.
All drawings prepared by UVAdesign Ltd are not to be used for any submissions, area schedule calculation or used by any other persons or companies other than UVAdesign Ltd unless written consent has been given by UVAdesign Ltd.