


Like for like white aluminum windows to replace all 8 of the current white aluminum windows numbered 01 to 08 as indicated in red.

It is proposed that all windows will have like for like openers, except for windows no. 03 and no.08 where it is proposed to turn the two fixed glass bottom panels into openers as indicated in red. These windows currently only have one opener at the top panel.

Comments added by Enn Studio Ltd.  
For the purpose of a Lawful Development  
Certificate Application 21st June 2022

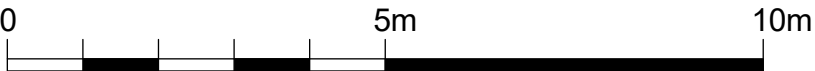

Written dimensions to be taken in preferences to scaled dimensions. The Contractor is responsible for checking all dimensions before work starts.

All work is to be carried out to the requirements, and to the satisfaction of the Local Authority.

These drawings are for planning purposes only

Any discrepancies to be brought to the attention of 4D Planning Consultants immediately.

Description

Rev	Date	Description	by	chk

**4D PLANNING™**  
Chartered Town Planners & Architectural Technicians

Architecture | Town Planning

T: 0203 1500 183    www.GetMePlanning.com

www.GetMePlanning.com

Client  
Mr Kyle Duncan

Project  
252 Gray's Inn Road, WC1X  
8JT

Title EXISTING DRAWINGS ELEVATIONS	
Date: 04.10.2021	Rev:
Scale: 1:100@A3	
Drawing No.4D-181 E 02	
Drawn by : MAX	