MARIS

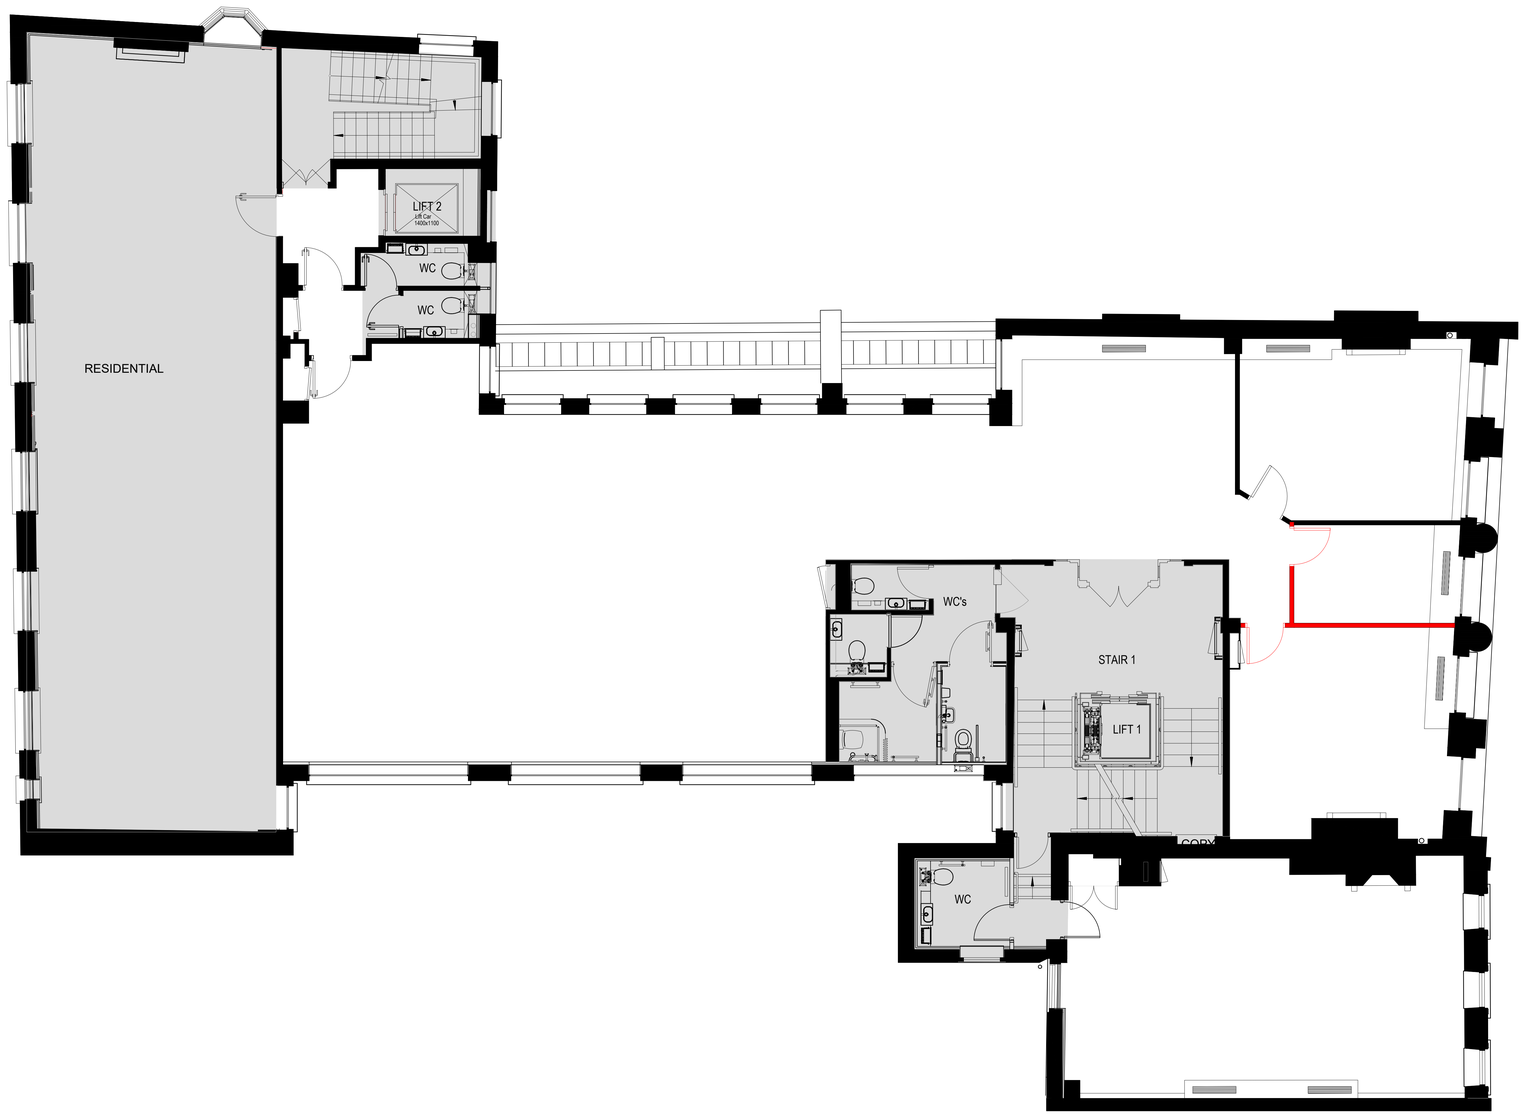

1:50 Scale

0m 1m 2m 3m 4m 5m 6m 7m 8m

Floor 02

KEY TO DEMOLITIONS DRAWING

Some symbols shown may not appear in drawing, and may not be to scale. Drawing must be printed in colour.

Existing fit-out (do not remove)

Existing basebuild wall or partitioning
Existing glazing
Existing solid single door
Existing glass single door
Existing solid double door

Existing fit-out to be carefully stripped out

Existing partitioning to be removed
Existing glazing to be removed
Existing solid single door to be removed
Existing glass single door to be removed
Existing solid double door to be removed

REV	DESCRIPTION	BY	DATE
-	Drawing first produced	KM	11/07/2022

DRAWING STATUS
PRE CONSTRUCTION

The Mission Group

Address
30-32 Great Queen Street
Covent Garden
London WC2B 5BL

Project Number	Ref	Floor	Detail
31562	00	02	DEM

Drawing Title
Proposed Second Floor Demolitions

Produced by	Scale	Date Created	Rev
KM	1:50@A0	11/07/2022	-

MARIS
The Harlequin Building
65 Southwark Street
London SE1 0HR
T 020 7902 1866
E hello@maris.co.uk
W maris.co.uk

MARIS

© MARIS INTERIORS LLP Property & Copyright
Use of drawings is not permitted for use if they be copied, duplicated or distributed without the consent of the LLP.

All designs are the sole property of MARIS INTERIORS LLP, and may not be used, transferred, or disclosed to a third party without the express permission of MARIS INTERIORS LLP. Electronic copies of this drawing are supplied for convenience only. No dimensions or other information should be used from the electronic copy. Do not scale from this drawing. Figured dimensions only are to be used. For Construction and any scaling of the drawing will be at the Contractor's risk. Contractor to verify all dimensions, levels, and components on site. Any discrepancies shall be addressed in writing to this office for clarification prior to the commencement of the work, otherwise the Contractor shall bear full responsibility for any associated cost. Any claims for variations or extras shall be submitted to this office for assessment prior to approval of any such variation or extra. This drawing is to be read in conjunction with all other Contract documentation. This drawing must be signed otherwise it will be invalid. Building parameters taken from as built drawings provided. Check survey undertaken only, subject to statutory approval. All dimensions shown are in millimetres unless otherwise shown.