

Issue ID	Issue Name	Date
02	Issue for planning	27/06/2022
01	Issue for planning	14/05/2022
00	Issue for planning	26/01/2022

Notes:
All dimensions must be checked and UVAdesign Ltd is to be informed of any discrepancies prior to construction. All drawings prepared by UVAdesign Ltd are not to be used for any submissions, area schedule calculation or used by any other persons or companies other than UVAdesign Ltd unless written consent has been given by UVAdesign Ltd.

T: +44 (0) 20 7371 57 97
 E: hello@uvadesign.co.uk
 W: www.uvadesign.co.uk
 A: 88 Peterborough road, Fulham SW6 3HH




UVAdesign Ltd

Project: Former Hampstead Police Station Stables
 London NW3 1PD

Layout Title: DEMOLITION MARK UP
 Floor plans
 Status: Planning

Issue date	Drawn by	Project code	Number	Rev
27/06/2022	@A3	113-21	DM.01	02
Scale: 1:100				

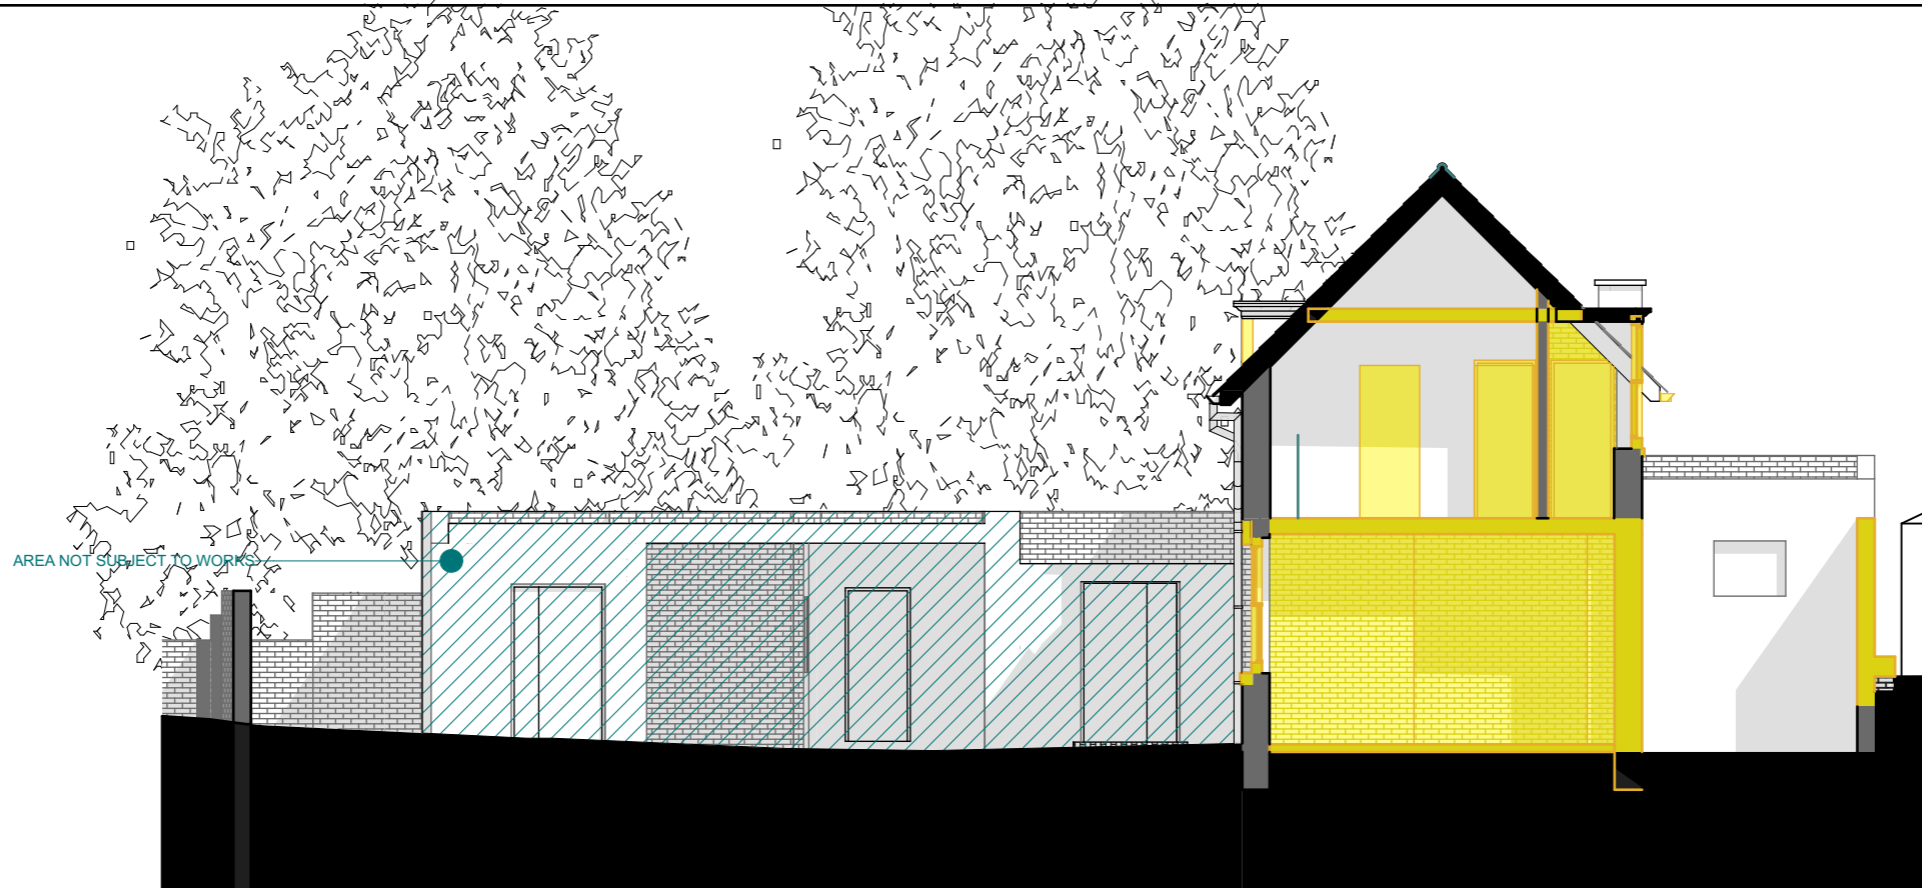

Issue ID	Issue Name	Date
02	Issue for planning	27/06/2022
01	Issue for planning	14/05/2022
00	Issue for planning	26/01/2022

Notes:
All dimensions must be checked and UVAdesign Ltd is to be informed of any discrepancies prior to construction. All drawings prepared by UVAdesign Ltd are not to be used for any submissions, area schedule calculation or used by any other persons or companies other than UVAdesign Ltd unless written consent has been given by UVAdesign Ltd.


T: +44 (0) 20 7371 57 97
E: hello@uvadesign.co.uk
W: www.uvadesign.co.uk
A: 88 Peterborough road
Fulham SW6 3HH



Project:	Former Hampstead Police Station Stables London NW3 1PD
----------	---

Layout Title:	DEMOLITION MARK UP
Status:	Planning

Issue date	27/06/2022	Drawn by	@A3	Project code	113-21	Number	DM.02	Rev	02
Scale:	1:100								

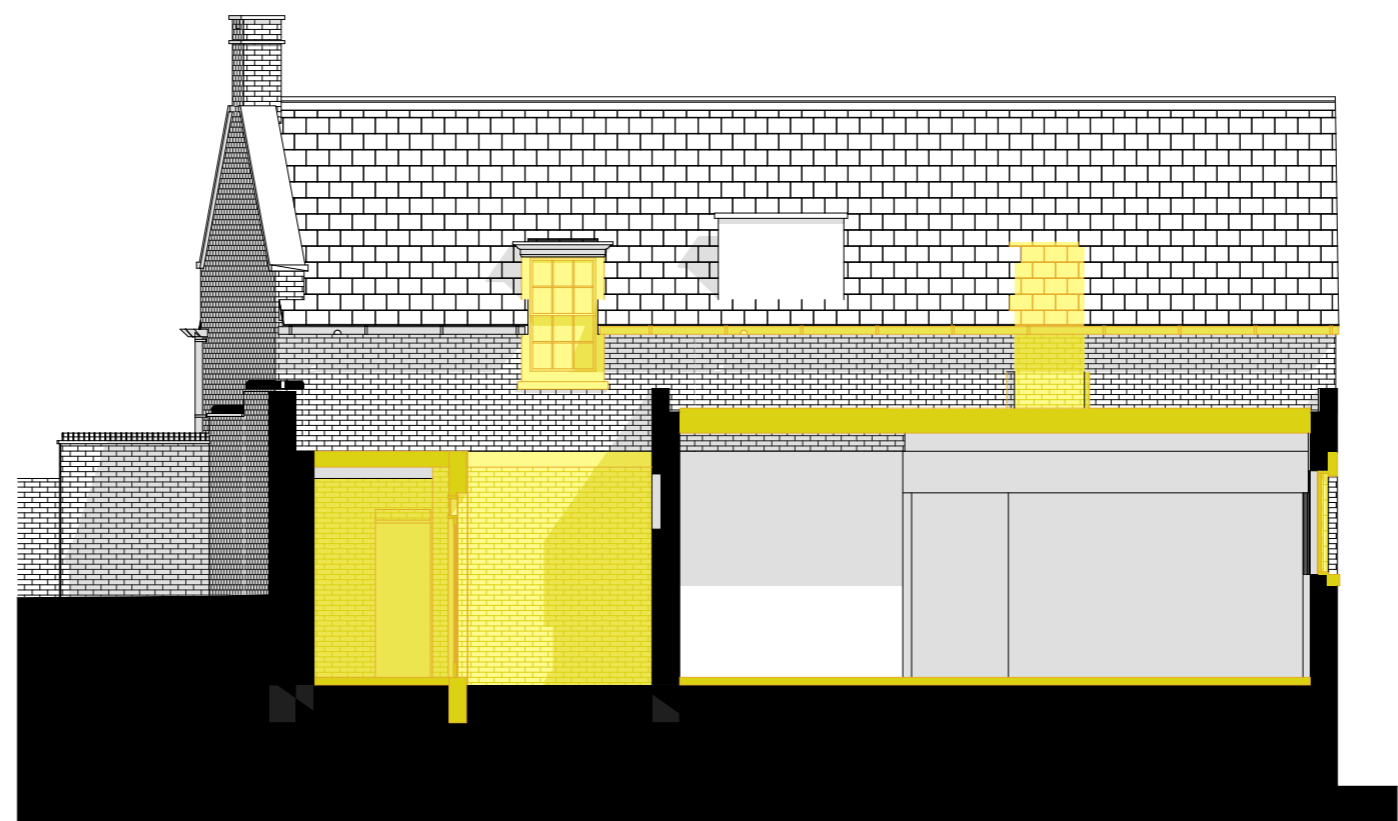

Issue ID	Issue Name	Date	Notes:
02	Issue for planning	27/06/2022	
01	Issue for planning	14/05/2022	
00	Issue for planning	26/01/2022	

Notes:
All dimensions must be checked and UVAdesign Ltd is to be informed of any discrepancies prior to construction.
All drawings prepared by UVAdesign Ltd are not to be used for any submissions, area schedule calculation or used by any other persons or companies other than UVAdesign Ltd unless written consent has been given by UVAdesign Ltd.

T: +44 (0) 20 7371 57 97
E: hello@uvadesign.co.uk
W: www.uvadesign.co.uk
A: 88 Peterborough road
Fulham SW6 3HH



Project:
Former Hampstead Police Station Stables
London NW3 1PD

Layout Title:
DEMOLITION MARK UP
Elevations and Sections
Status:
Planning

Issue date	Drawn by	Project code	Number	Rev
27/06/2022		113-21	DM.03	02
Scale:	1:100			
	@A3			



Issue ID	Issue Name	Date	Notes:
02	Issue for planning	27/06/2022	
01	Issue for planning	14/05/2022	
00	Issue for planning	26/01/2022	

T: +44 (0) 20 7371 57 97
 E: hello@uvadesign.co.uk
 W: www.uvadesign.co.uk
 A: 88 Peterborough road
 Fulham SW6 3HH

UVAdesign Ltd



Project:	Layout Title:	Issue date	Drawn by	Project code	Number	Rev
Former Hampstead Police Station Stables London NW3 1PD	DEMOLITION MARK UP Elevations and Sections	27/06/2022		113-21	DM.04	02
	Status:	Scale:	@A3			
	Planning	1:100				

Notes:
 All dimensions must be checked and UVAdesign Ltd is to be informed of any discrepancies prior to construction.
 All drawings prepared by UVAdesign Ltd are not to be used for any submissions, area schedule calculation or used by any other persons or companies other than UVAdesign Ltd unless written consent has been given by UVAdesign Ltd.