KEY:

▽	Floor Level
△	Ceiling Level
svp	Soil and Vent Pipe
rwp	Rain Water Pipe
ic	Inspection Cover
cl	Cover Level
u/s	Underside Height
BH 2000	Beam Height
AH 2500	Arch Head
SPR 1800	Spring Point
FS 0780	Floor to Sill
SH 1850	Sill to Head
	Drainage
	Boundary Line
	Above
	New Structure(130mm)/Insulation(215mm)
	Joinery
	Free-standing Furniture
	Radiator
C	Section Marker

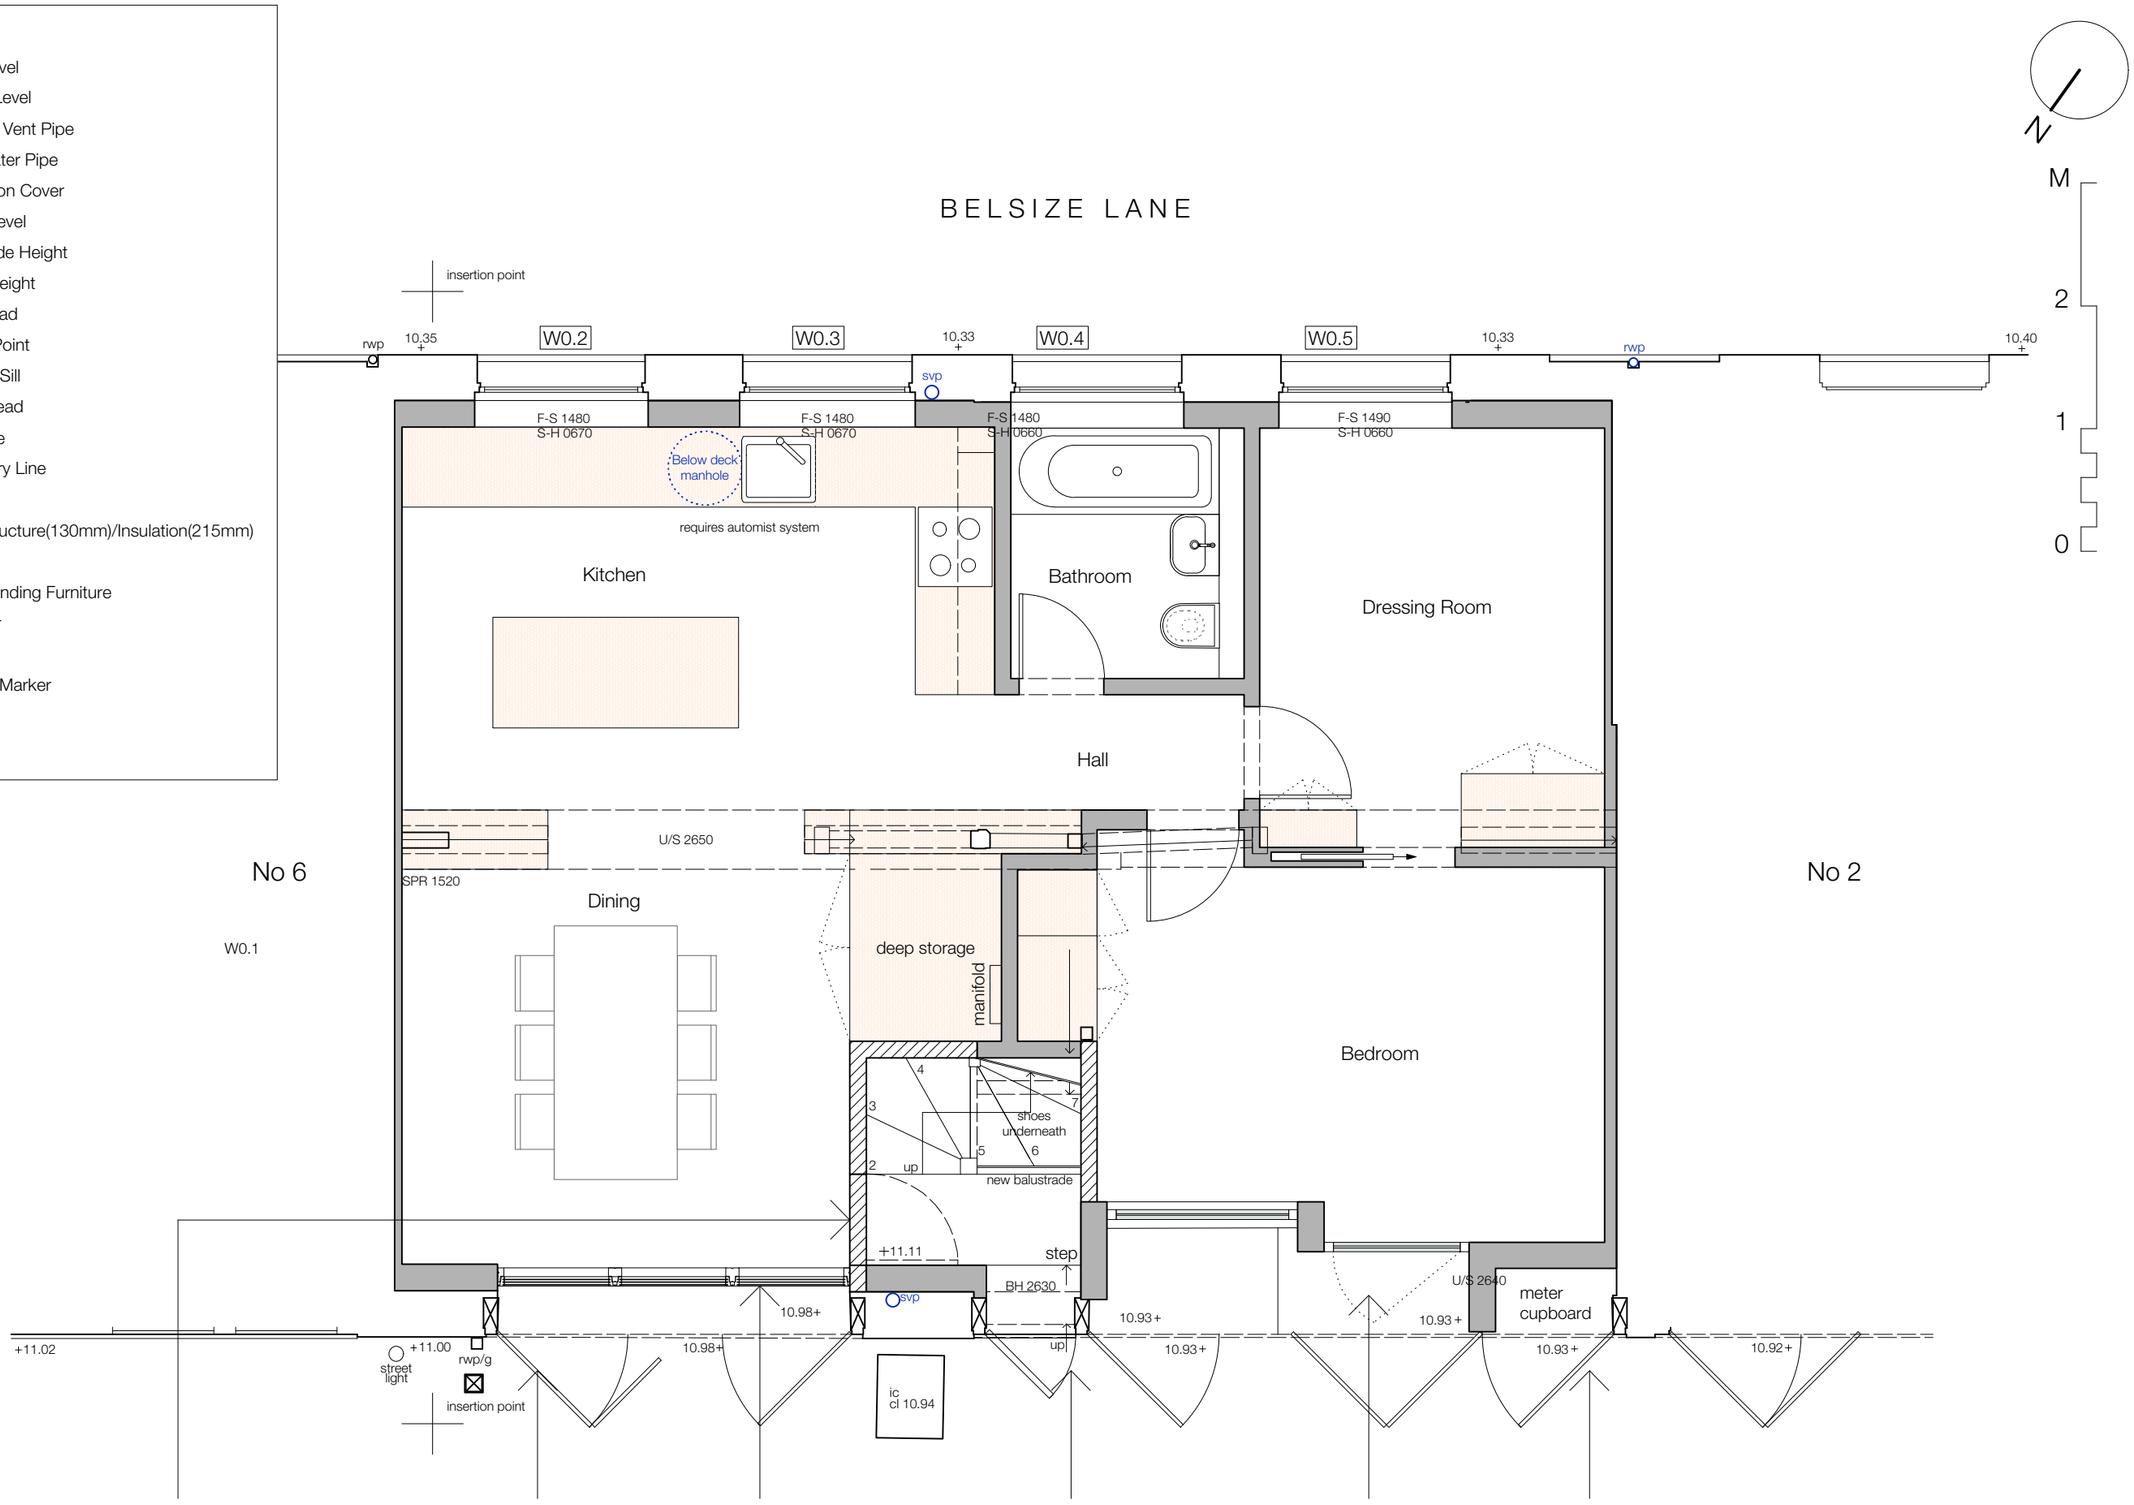

Blocked door opening creating temporary division to 2 flats. Fully reversible.

Existing Garage Doors Retained

Temporary entrance to the Ground Floor Flat through the glazed door.

New insulated door. Main entrance.

External Bike Store Behind Garage Doors

Existing Garage Doors Retained

BELSIZE COURT GARAGES

SANYA POLESCUK ARCHITECTS
8a BELSIZE COURT GARAGES LONDON NW3 5AJ
T:0207 431 8580 e-mail:enquiries@polescukarchitects.com

NO: P100

REV: PL1

DATE: 29 September 2022

PAPER: A3

SCALE: 1:50

TITLE: Ground Floor Plan (as built)

PROJECT: 4 Belsize Court Garages, London